


PROFILE	DATE
SURVEYED	
PLANNED	
NOTED	
STRUCTURE	
NOTATIONS	

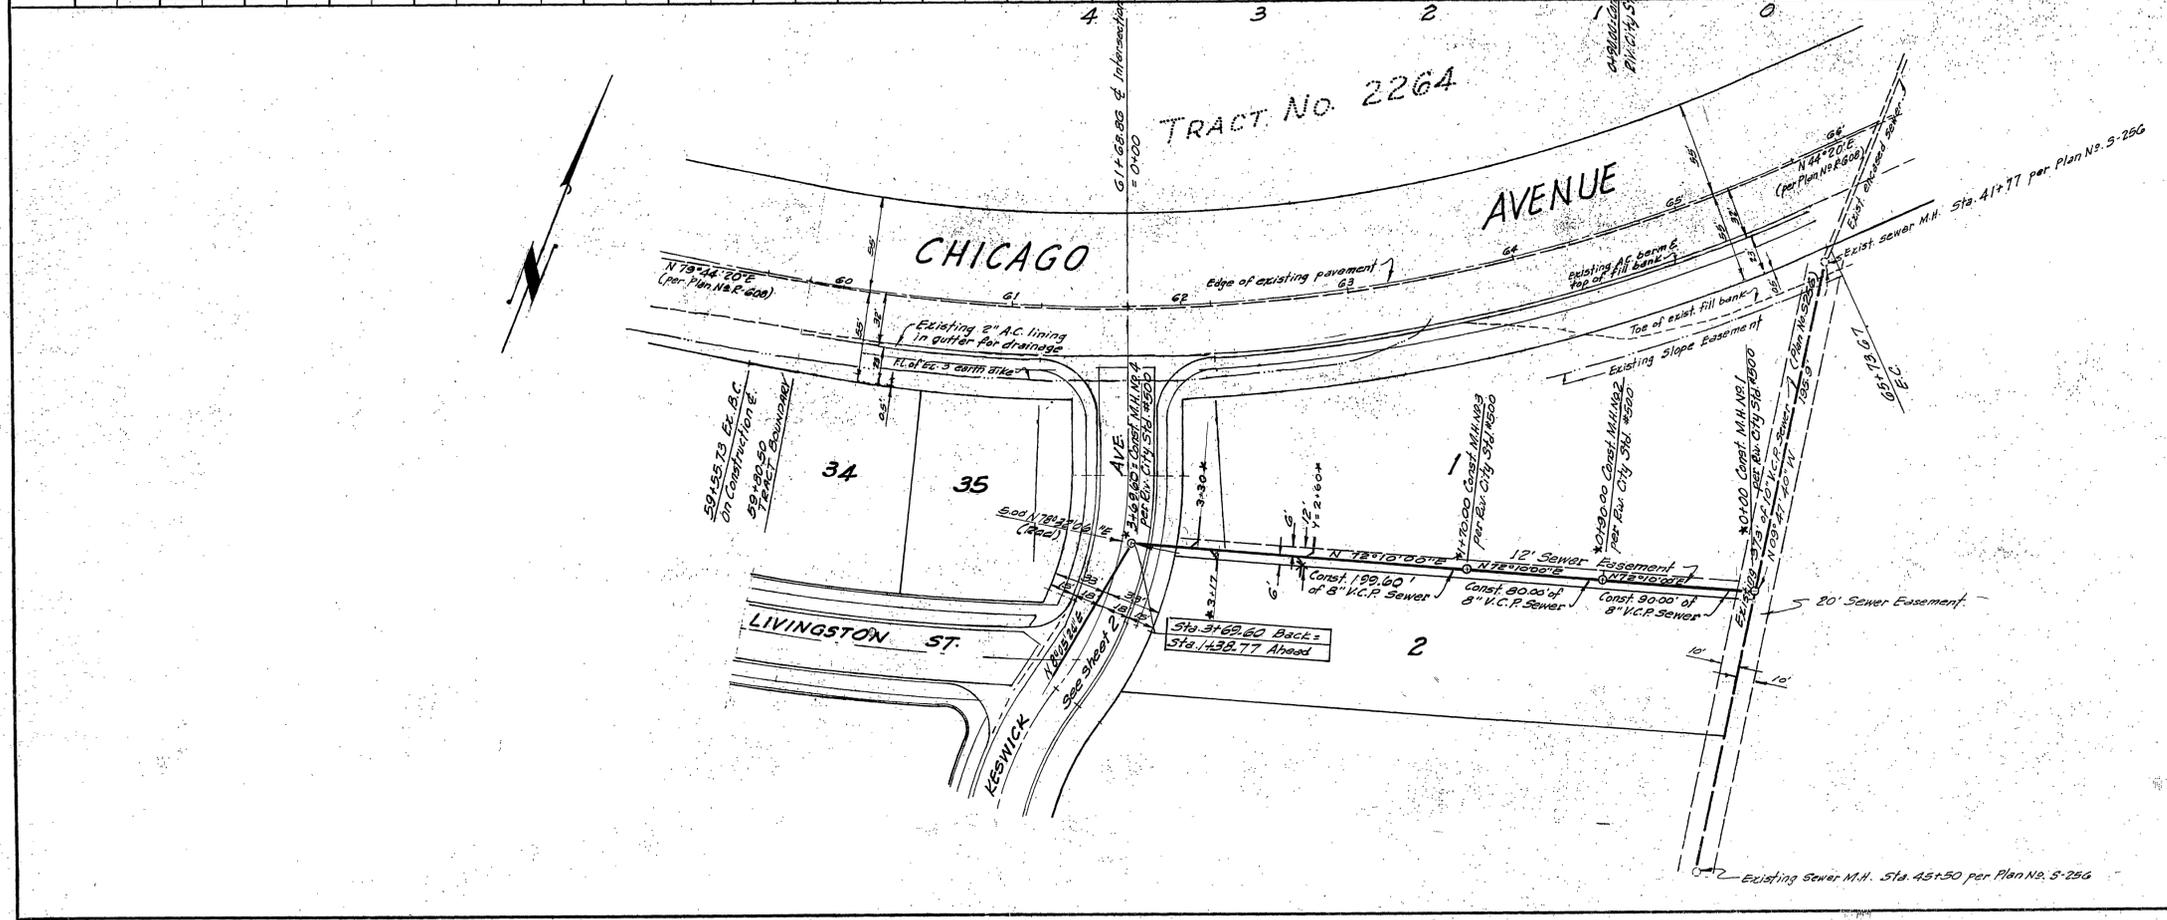

GENERAL NOTES:

1. It shall be the responsibility of the Contractor to clear the right of way in accordance of the provision of law as it affects each utility.
2. All construction to be done in accordance to Plans and Specifications No. 461 of the City of Riverside.
3. All wyes and laterals to be located in the field.
4. All laterals shall be 4" V.C.P. and extend to property line as per standard Drawing No. 562.
5. Pipes shall be bedded per Case II as per standard Drawing No. 452.
6. Joints in V.C.P. sewer shall conform to A.S.T.M. C-425-60T, or the latest revision thereto.
7. Adjust manhole rims to meet finished ground surface in easements, or M.H. No. 1 to be raised above flow line of channel as directed in the field.

BENCH MARK: 3/4" I.P. on property line 55' north of Chicago Ave. Sta. 63+00 (approx.)
Elevation: 1193.84


MCKEE & CRAWLEY
SURVEYORS AND ENGINEERS
Riverside, California
Approved: *George O. Crawley* Field Bk. LB 21/14
Date: 4/15/64
(P.E. No. 9455)

REVISIONS		
MARK	DATE	DESCRIPTION
*	7-3-64	As built BE


CITY OF RIVERSIDE CALIFORNIA
DEPARTMENT OF PUBLIC WORKS
SEWER PLAN & PROFILE
BETWEEN KESWICK AVENUE
AND E'LY TRACT BOUNDARY
TRACT NO. 2648
HORIZ. SCALE: 1"=50' VERT. SCALE: 1"=10'

DESIGNED BY	CHECKED BY <i>Ron</i>	APPROVED BY <i>George O. Crawley</i>	SHEET 1 OF 3
DRAWN BY		DIRECTOR OF PUBLIC WORKS	
RECOMMENDED BY <i>Paul</i>	ASSISTANT CITY ENGINEER	DATE 9-29-64	

PLAN	DATE
SURVEYED	
PLANNED	
NOTED	
STRUCTURE	
NOTATIONS	

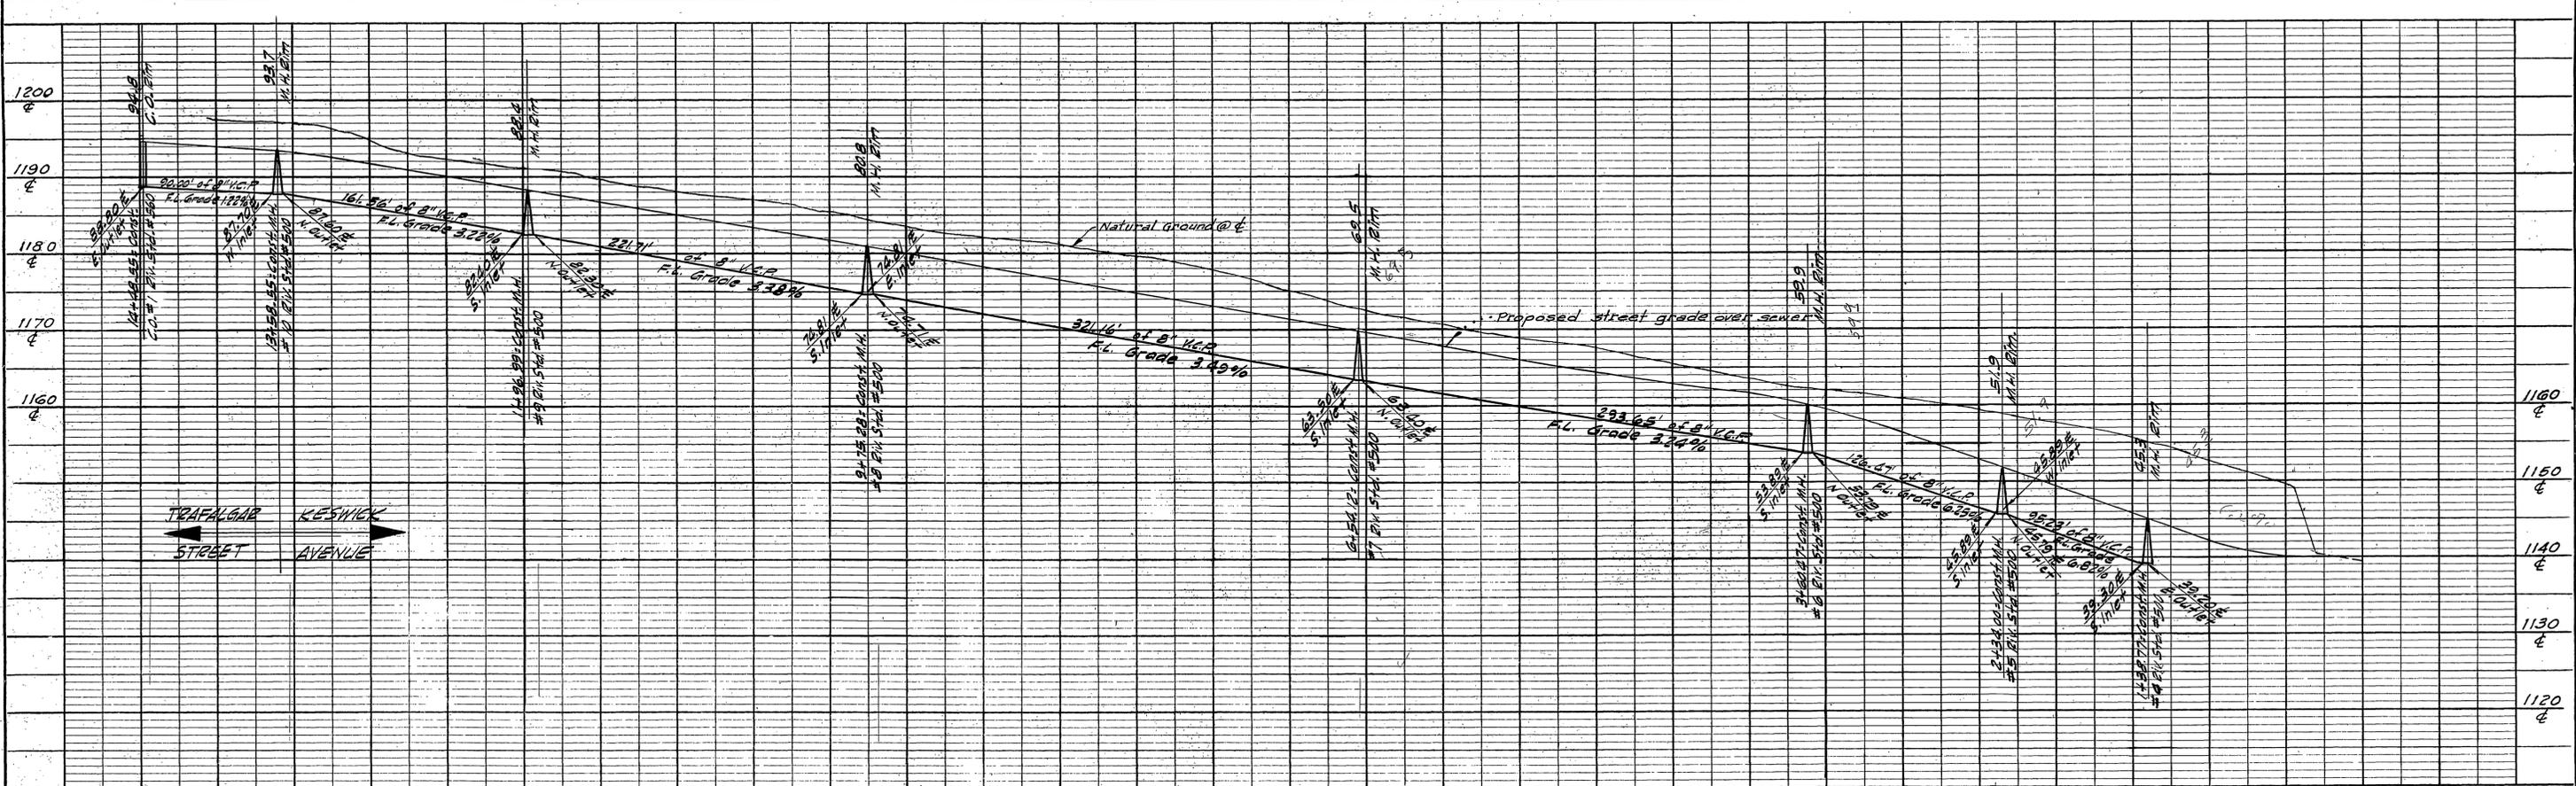

NO.	PROFILE	DATE
	SURVEYED	
	PLANNED	
	CHECKED	
	STRUCTURE	
	ADJUSTING	
	BY	
	DATE	

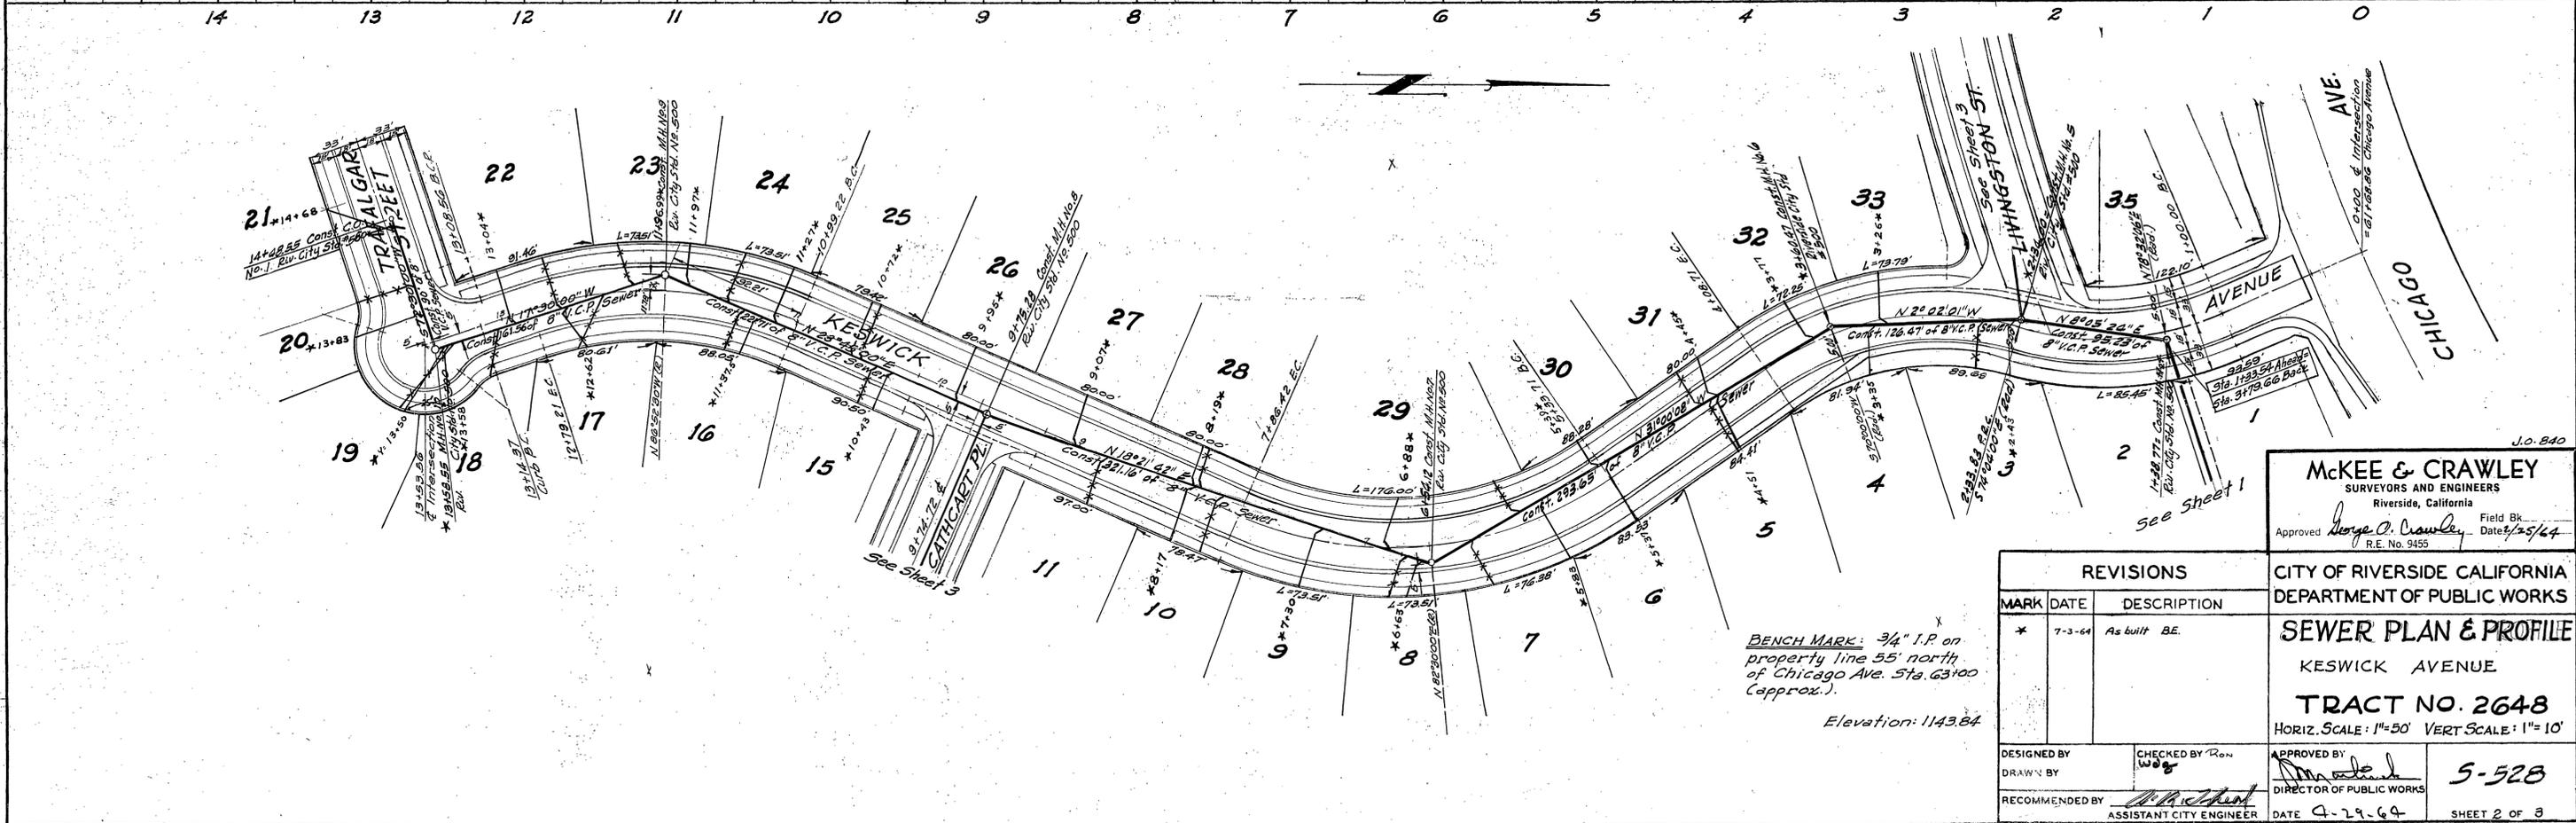

NO.	PLAN	DATE
	SURVEYED	
	PLANNED	
	CHECKED	
	BY	
	DATE	

McKee & Crawley
 SURVEYORS AND ENGINEERS
 Riverside, California
 Approved *George O. Crawley* Date 7/25/64
 R.E. No. 9455




REVISIONS		
MARK	DATE	DESCRIPTION
*	7-3-64	As built B.E.

CITY OF RIVERSIDE CALIFORNIA
 DEPARTMENT OF PUBLIC WORKS
SEWER PLAN & PROFILE
 KESWICK AVENUE
TRACT NO. 2648
 HORIZ. SCALE: 1"=50' VERT. SCALE: 1"=10'

DESIGNED BY
 DRAWN BY
 RECOMMENDED BY *[Signature]*
 ASSISTANT CITY ENGINEER

CHECKED BY *[Signature]*
 APPROVED BY *[Signature]*
 DIRECTOR OF PUBLIC WORKS
 DATE 4-29-64
5-528
 SHEET 2 OF 3

BENCH MARK: 3/4" I.P. on property line 55' north of Chicago Ave. Sta. 63+00 (approx).
 Elevation: 1143.84

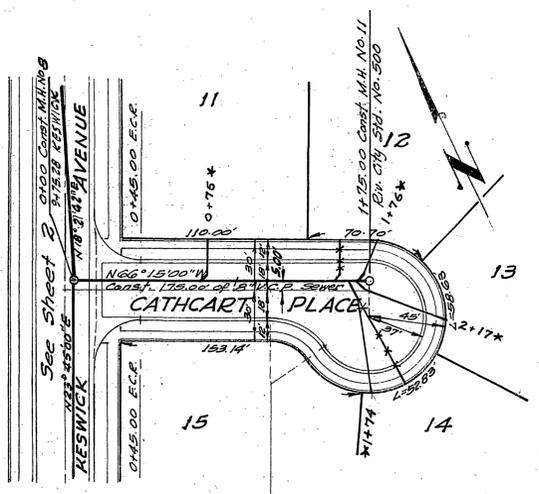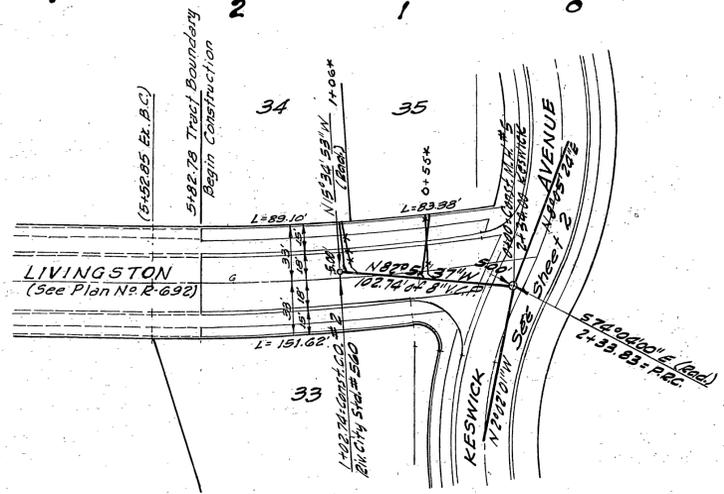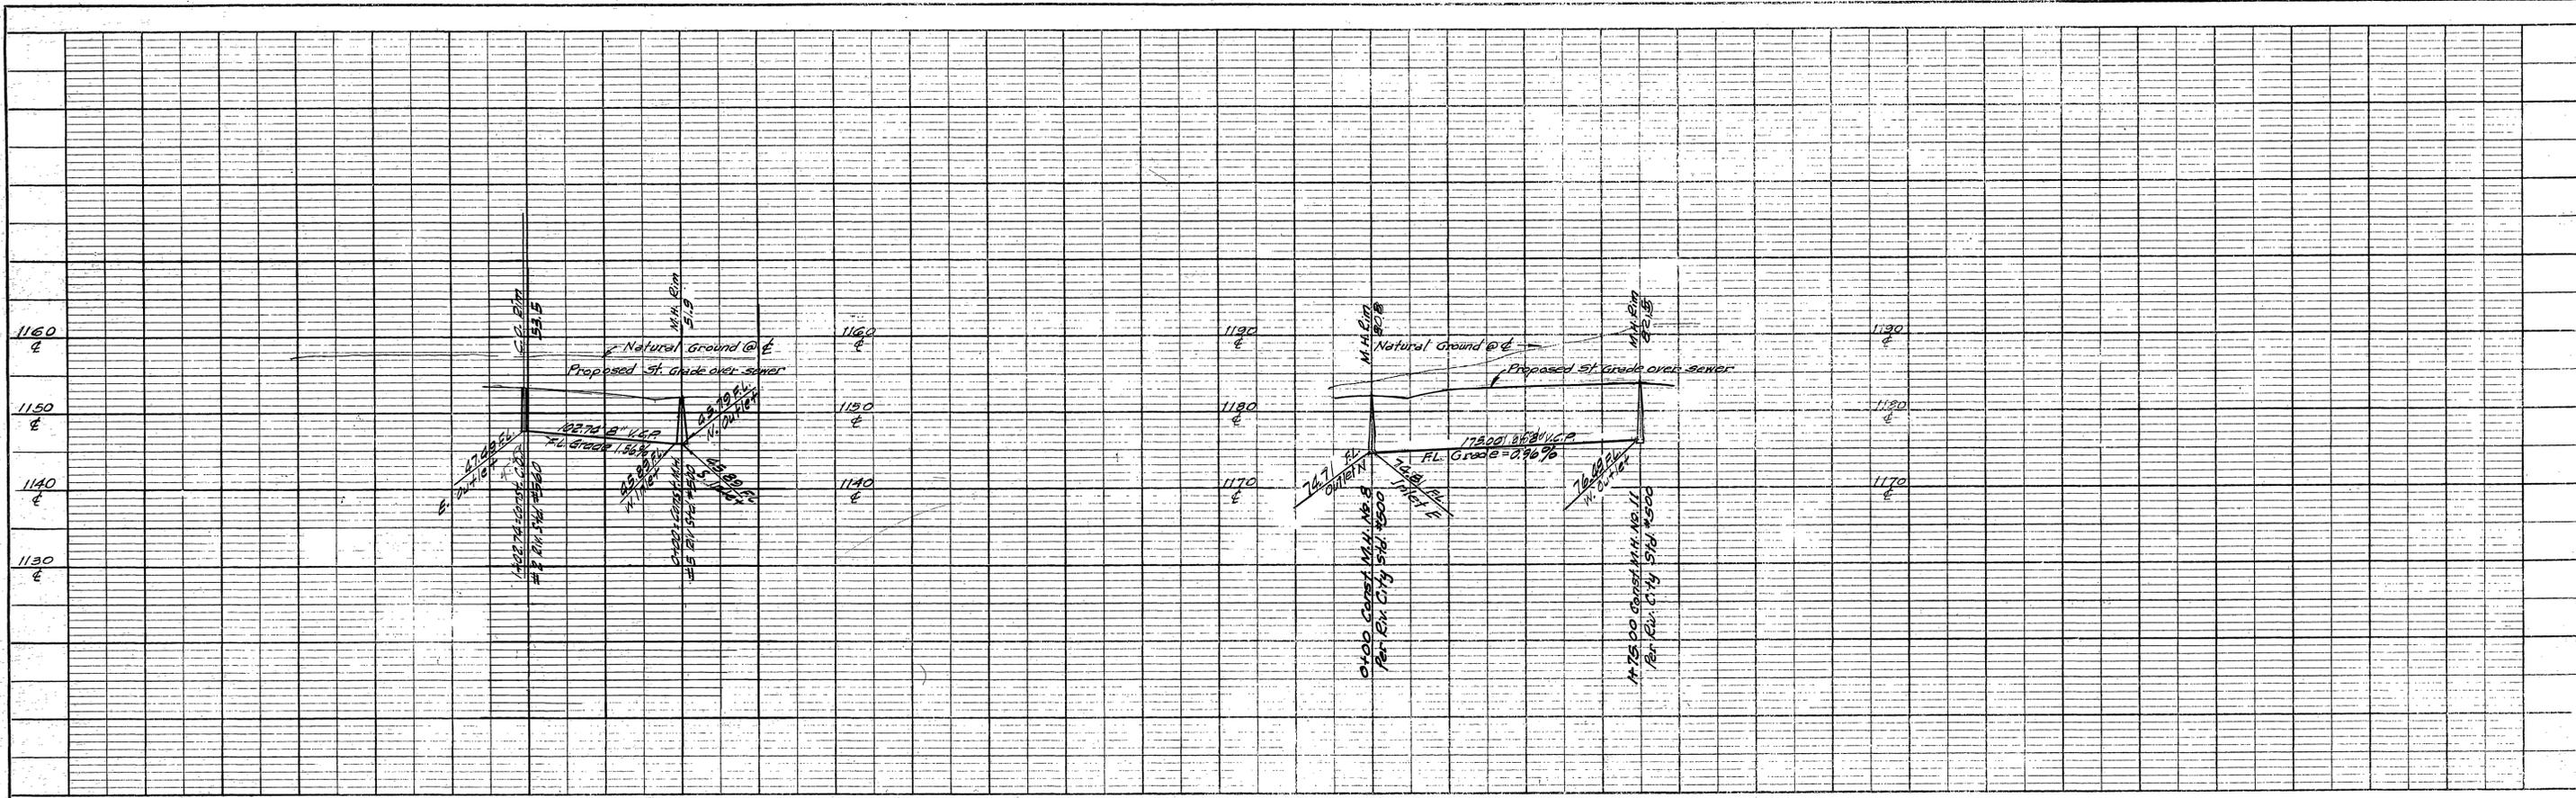

BENCH MARK: 3/4" I.P. on property line 55' north of Chicago Ave. Sta. 63+00 (approx.)
 Elevation: 1143.84

McKEE & CRAWLEY
 SURVEYORS AND ENGINEERS
 Riverside, California
 Approved: *George O. Crowley* Date: 4/25/64
 R.E. No. 9455

REVISIONS		
MARK	DATE	DESCRIPTION
*	7-3-64	As built BE.

DESIGNED BY: _____
 DRAWN BY: _____
 CHECKED BY: *Ron*
 RECOMMENDED BY: *G. J. Schul*
 ASSISTANT CITY ENGINEER

APPROVED BY: *George O. Crowley*
 DIRECTOR OF PUBLIC WORKS
 DATE: 4-22-64

CITY OF RIVERSIDE CALIFORNIA
 DEPARTMENT OF PUBLIC WORKS
SEWER PLAN & PROFILE
 LIVINGSTON STREET
 CATHCART PLACE
TRACT NO. 2648
 HORIZ. SCALE: 1"=50' VERT. SCALE: 1"=10'

S-528
 SHEET 3 OF 3

NO.	DATE	BY

NO.	DATE	BY